



- GENERAL NOTES**
- CONNECT LIGHT FIXTURES TO EXISTING BRANCH CIRCUIT CONDUIT AND CONDUCTORS.
 - CONNECT RECEPTACLES TO EXISTING BRANCH CIRCUIT CONDUIT AND CONDUCTORS. PROVIDE FACEPLATES AND CLEAR LABEL WITH CIRCUIT INFORMATION.
 - CONNECT SWITCHES TO EXISTING BRANCH CIRCUIT CONDUIT AND CONDUCTORS. PROVIDE FACEPLATES AND CLEAR LABEL WITH CIRCUIT INFORMATION.
 - SEE "GENERAL FIRE PROTECTION NOTES", SHEET AEO01 FOR RATED WALLS AND ALL FLOOR PENETRATION REQUIREMENTS.
 - COORDINATE WORK ON THIS SHEET WITH IT RENOVATION PROJECT: "TELECOM ROOM UPGRADES, BGS PROJECT NO. 3231, DFE PROJECT NO. 235C19-310-D3" DRAWINGS PREPARED BY COLBY COMPANY ENGINEERING DATED AUGUST 10, 2023.



- KEYNOTES (THIS SHEET ONLY)**
- MOUNT LIGHT TO BOTTOM OF STRUCTURE IN SAME LOCATION AS REMOVED FIXTURE.
 - THIS FIXTURE CONTAINS EXISTING (TO REMAIN) LED LIGHT FIXTURES.

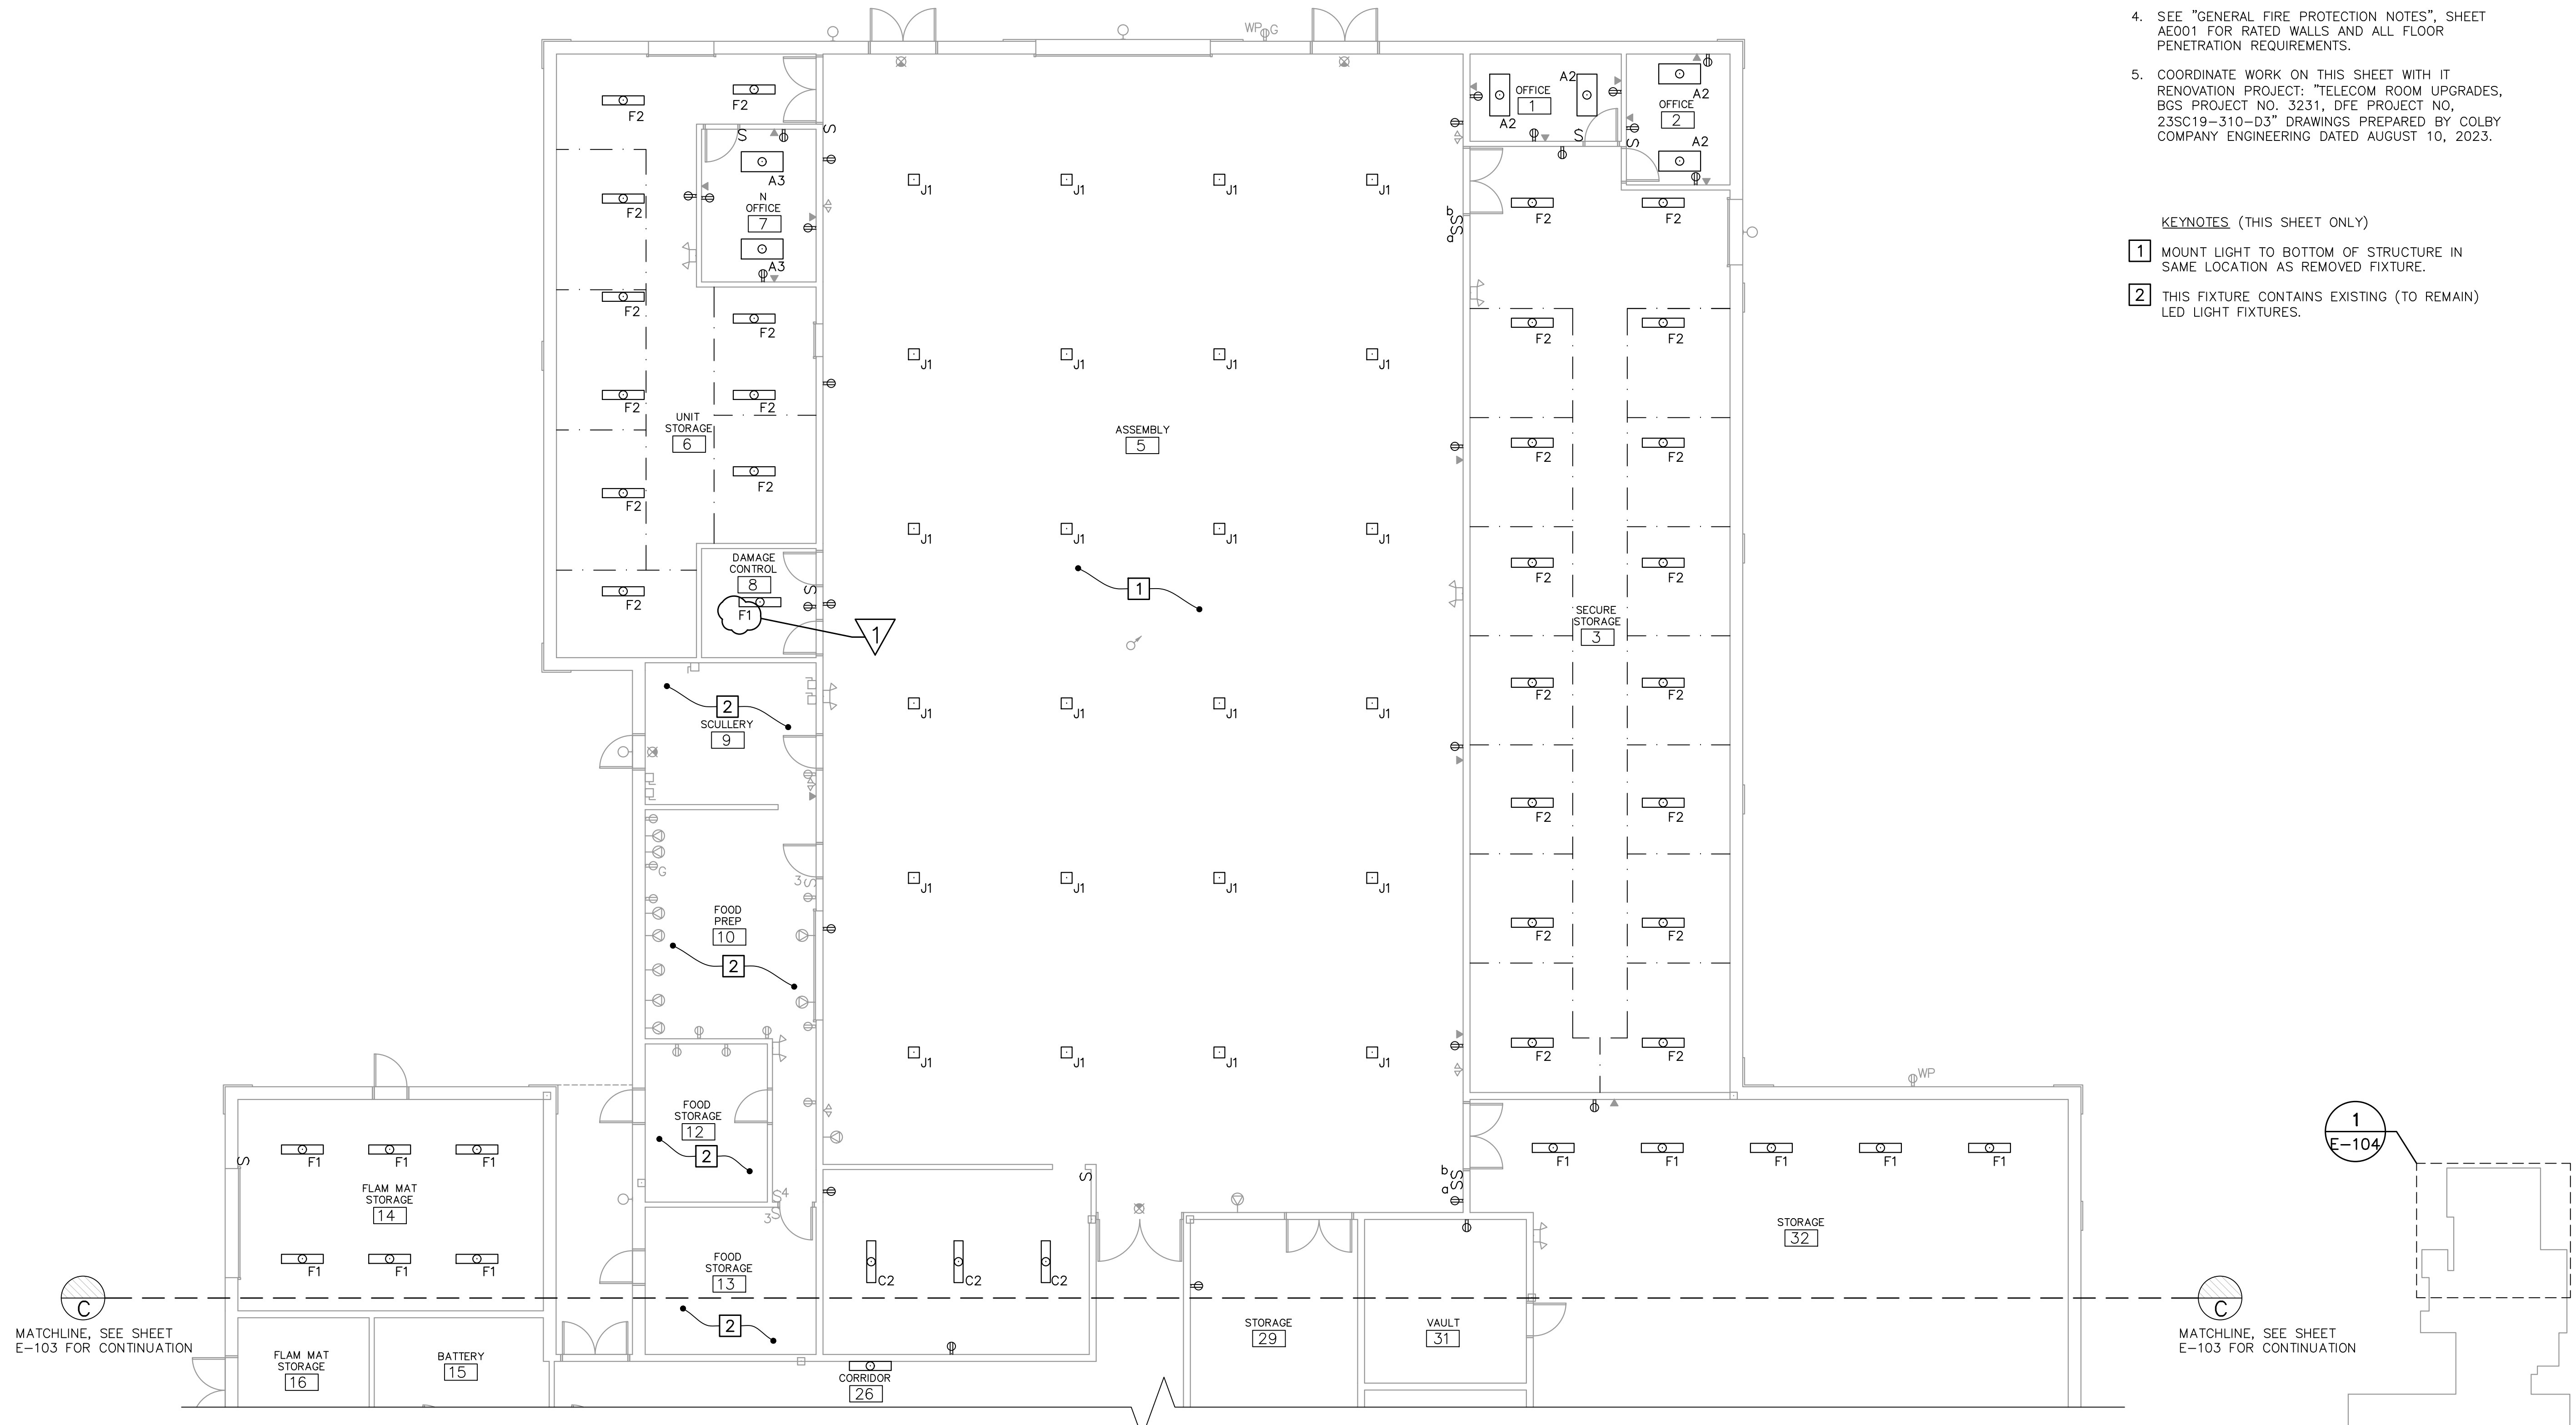

1 PARTIAL FIRST FLOOR ELECTRICAL PLAN
E-104 SCALE: 1/8"=1'-0"

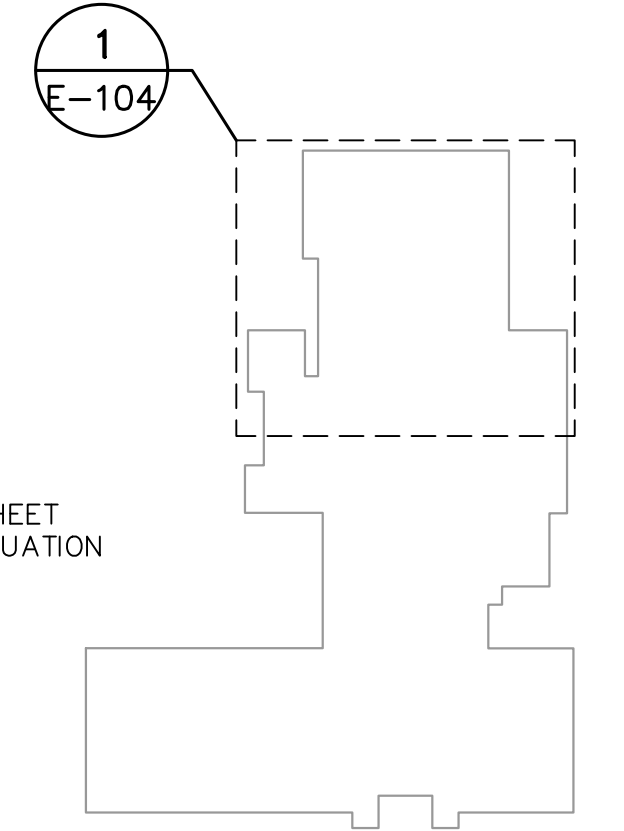

FIRST FLOOR KEYPLAN
NOT TO SCALE

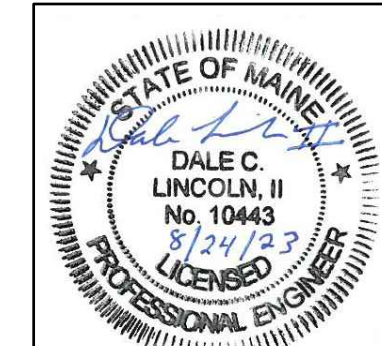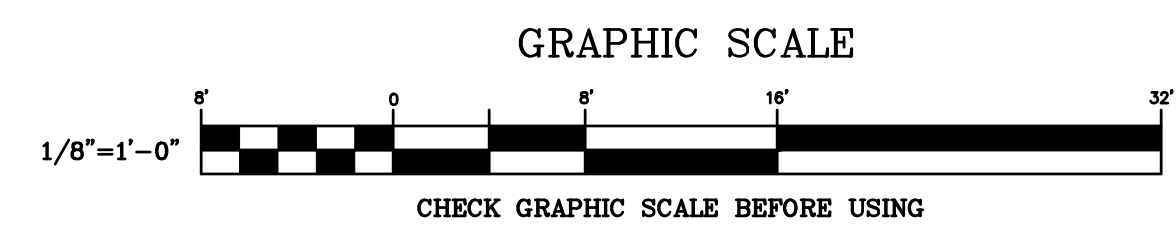

PLAN REVISIONS

Rev#	Description	Date	Appr.
1	ADDENDUM #2	8/24/23	

DESIGNED BY: MHL
DRAWN BY: RSW
CHECKED BY: DCL
DATE: 08/11/2023
SCALE: AS NOTED
DFE PROJECT NO: 235R22-401-1

STATE OF MAINE
DEPARTMENT OF DEFENSE, VETERANS
AND EMERGENCY MANAGEMENT
OAK POINT ASSOCIATES
ARCHITECTURE, ENGINEERING, & PLANNING
231 MAIN STREET
BIDDEFORD, MAINE
207-283-0193

AFRC RENOVATION
BANGOR, MAINE
PARTIAL
FIRST FLOOR ELECTRICAL PLAN - 4

PLAN PROGRESS

<input type="checkbox"/>	DRAFT
<input type="checkbox"/>	50% REVIEW
<input type="checkbox"/>	65% REVIEW
<input type="checkbox"/>	95% REVIEW
<input type="checkbox"/>	FINAL REVIEW
<input checked="" type="checkbox"/>	FOR BIDDING
<input type="checkbox"/>	ISSUED FOR CONSTRUCTION
<input type="checkbox"/>	RECORD DRAWINGS

SHEET ID:
E-104
SHEET: 85 OF 88